



IN THE UNITED STATES PATENT AND TRADEMARK OFFICE

Applicant : Salvatore Leonardi
Application No. : 09/853,833
Filed : May 10, 2001
For : INTEGRATED DEVICE WITH A TRENCH ISOLATION
STRUCTURE, AND FABRICATION PROCESS THEREFOR

Examiner : Leonardo Andujar
Art Unit : 2826
Docket No. : 856063.694
Date : September 30, 2002

Commissioner for Patents
Washington, DC 20231

RECEIVED
OCT 1 2002
TECHNOLOGY CENTER 2800

REQUEST FOR DRAWING CHANGE

Commissioner for Patents:

Drawing changes, as indicated in red on the attached drawings, are hereby submitted for approval by the Examiner.

Respectfully submitted,
Salvatore Leonardi
Seed Intellectual Property Law Group PLLC

E. Russell Tarleton
E. Russell Tarleton
Registration No. 31.800

ERT:aep

Enclosure:
Redlined Figures 3, 9, and 10

701 Fifth Avenue, Suite 6300
Seattle, Washington 98104-7092
Phone: (206) 622-4900
Fax: (206) 682-6031

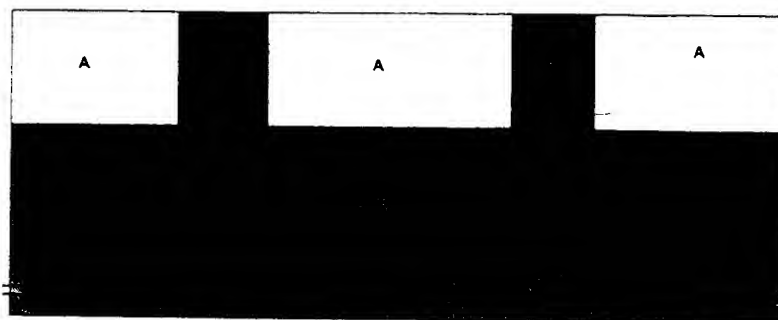


Figura 1

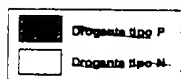


Figura 2

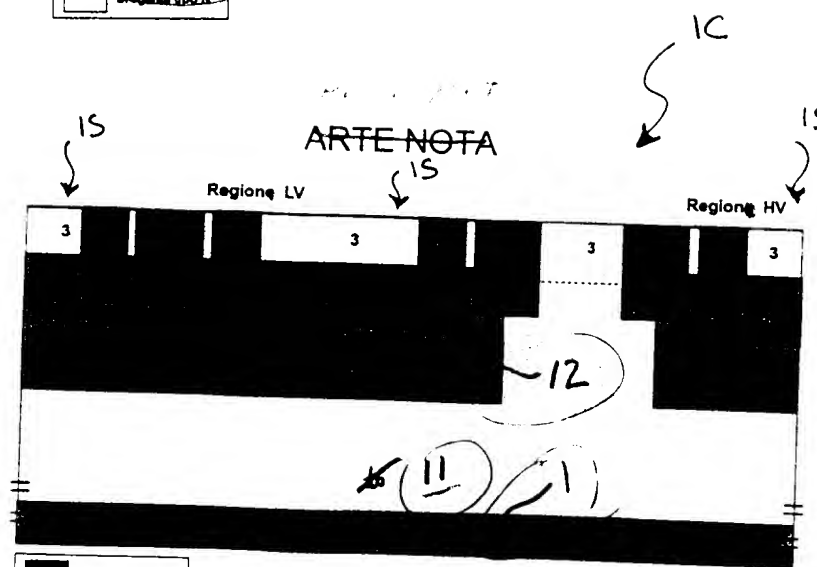
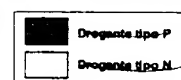
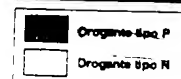


Figura 3



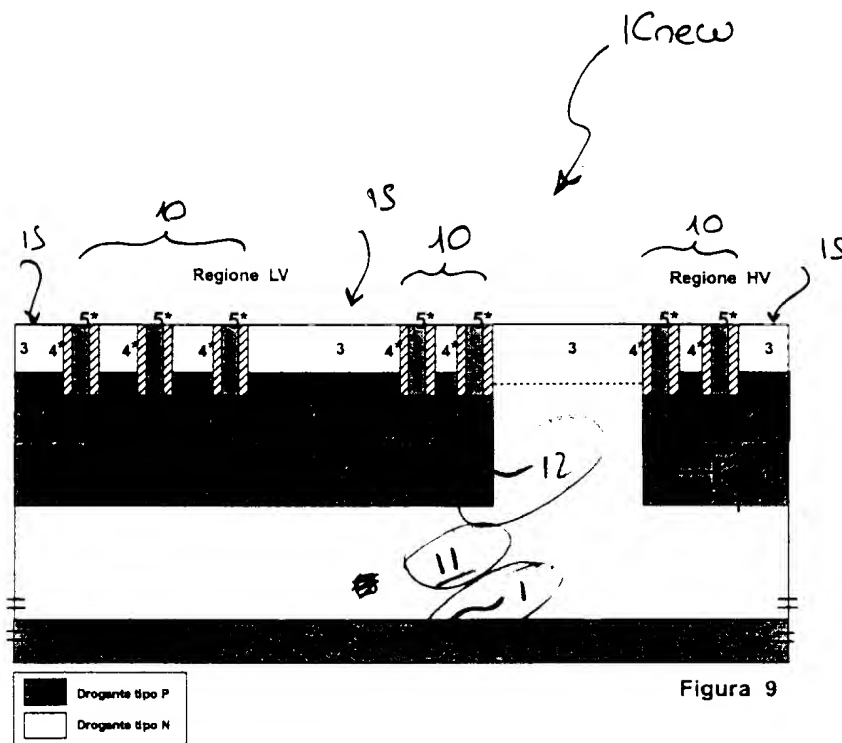


Figura 9

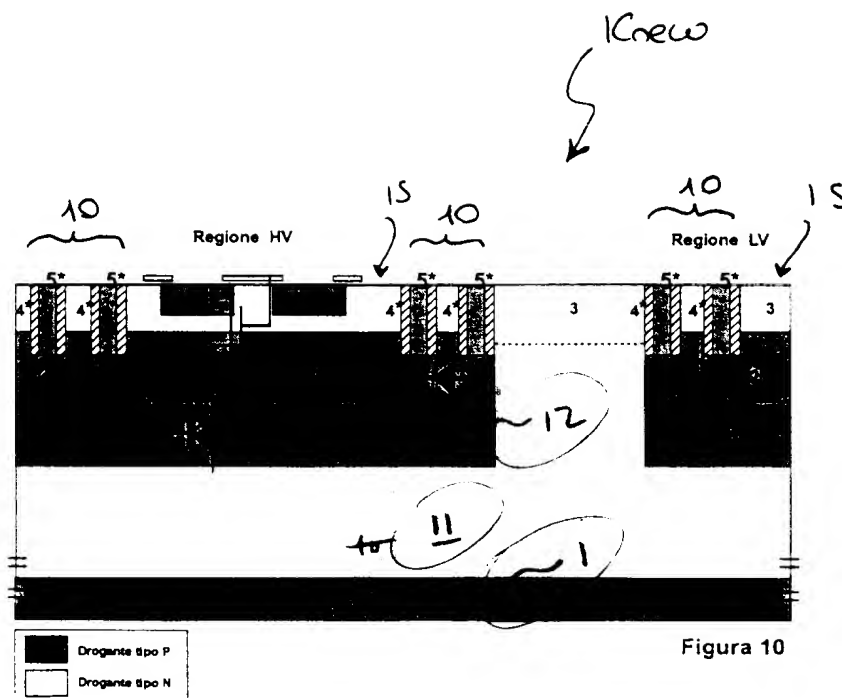


Figura 10